


RECEIVED
21/04/2026
**TOOWOOMBA
REGIONAL COUNCIL**



APPENDIX A – MARKED-UP SITE PLAN
SP Building Design

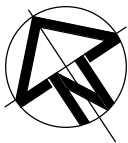

BUILDING DESIGN

spsbuildingdesign.com.au
0473 352 716

QBCC 15263359

© Copyright in whole or part
SP Building Design Pty Ltd
ABN 70 650 433 757

Designers shall not be responsible for
the structural design of the building.
Do not scale this drawing. Verify all
dimensions, details and notations
prior to construction.

DESIGNER :


A. Cooper

REVISION SCHEDULE



A CONCEPT DWGS 08.09.25



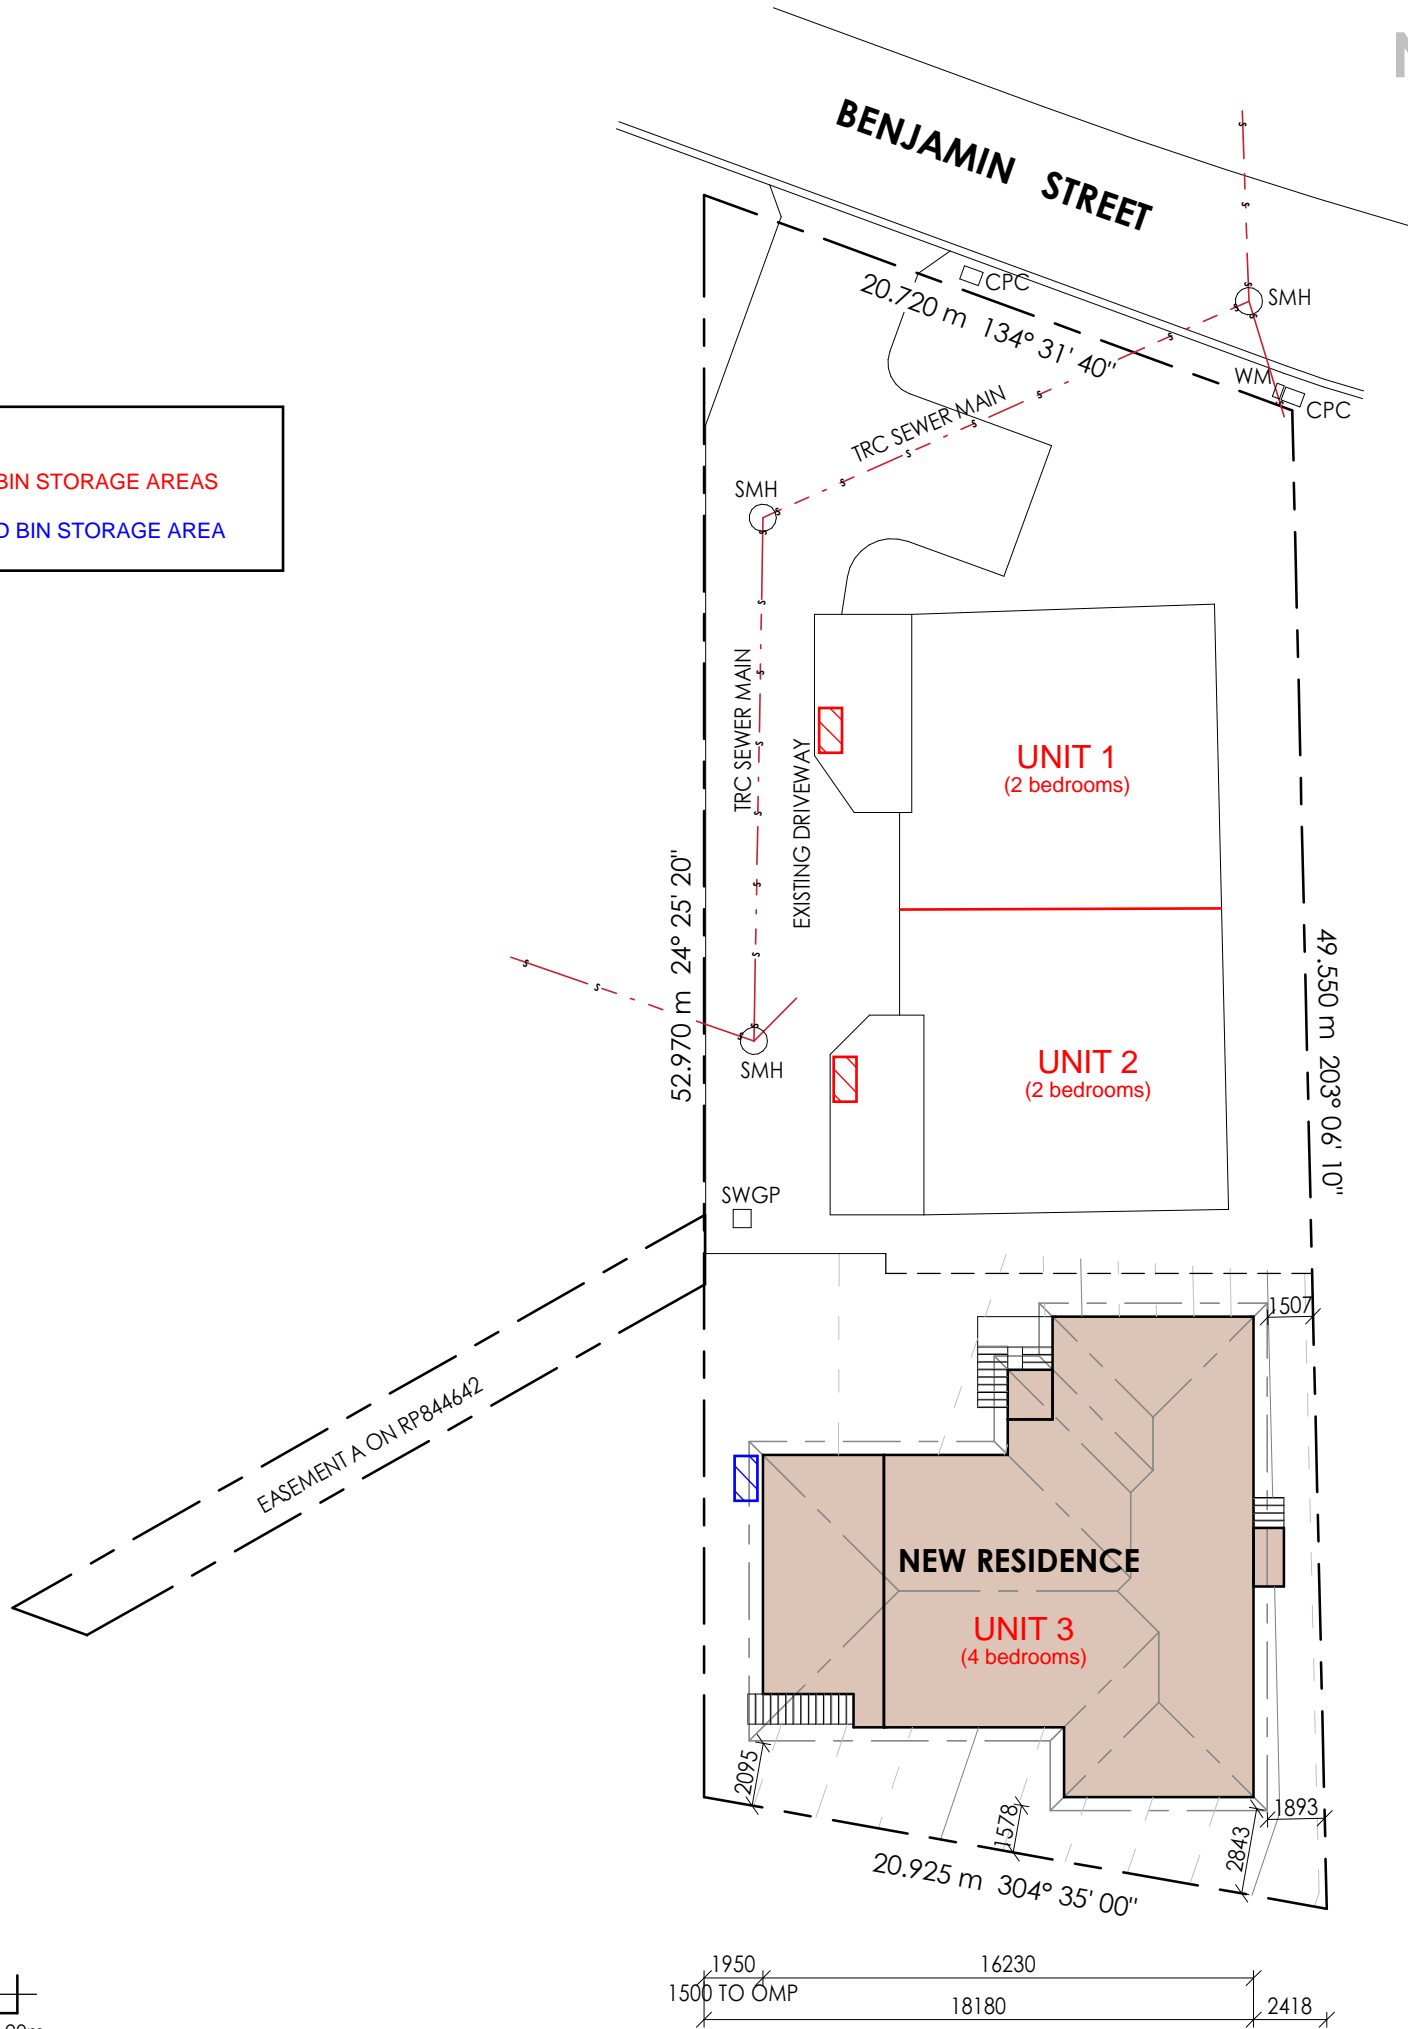

LEGEND

-  EXISTING BIN STORAGE AREAS
-  PROPOSED BIN STORAGE AREA



LEGEND

- AG ABOVE GROUND
- CL CLOTHES LINE
- CPC COMMUNICATIONS PIT COVER
- DD DRAINAGE DROPPER FRAMED OUT
- DP DOWNPIPE
- ES ELECTRICAL SERVICE LINE
- EP ELECTRICAL SERVICE PILLAR
- EPC ELECTRICAL PIT
- HSTP HOME SEWAGE TREATMENT PLANT
- OH OVERHEAD
- PP POWER POLE
- RB REFUSE BIN
- RTW RETAINING WALL
- RWT RAINWATER TANK
- SOP SETOUT POINT
- SMH SEWER MANHOLE COVER
- SWMH STORMWATER MANHOLE COVER
- UG UNDERGROUND
- WM WATER METER
-  BEARER AND JOIST CONSTRUCTION
-  SLAB ON GROUND CONSTRUCTION
- AT ARTIFICIAL TURF
- BFC BROOM FINISHED CONCRETE
- GR DECORATIVE GRAVEL
- PL IN GROUND PLANTING

-  ELECTRICAL
-  SEWER
-  STORMWATER
-  WATER

PROJECT DETAILS

NEW RESIDENCE

9 BENJAMIN ST,
MT LOFTY

LOT 0 ON BUP101164

PROJECT NUMBER : 250902

SCALE : As indicated

SHEET SIZE : A3


WIND CATEGORY :

1.01 - A



JUSTIN BOWE BUILDING
New Home | Design | Build
0458 340 064
QBCC: 15230179

SIGNATURES	
OWNER/S	_____
BUILDER	_____

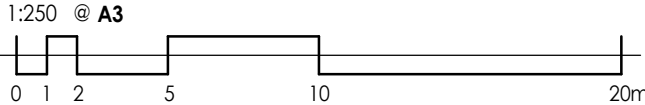

SITE PLAN