

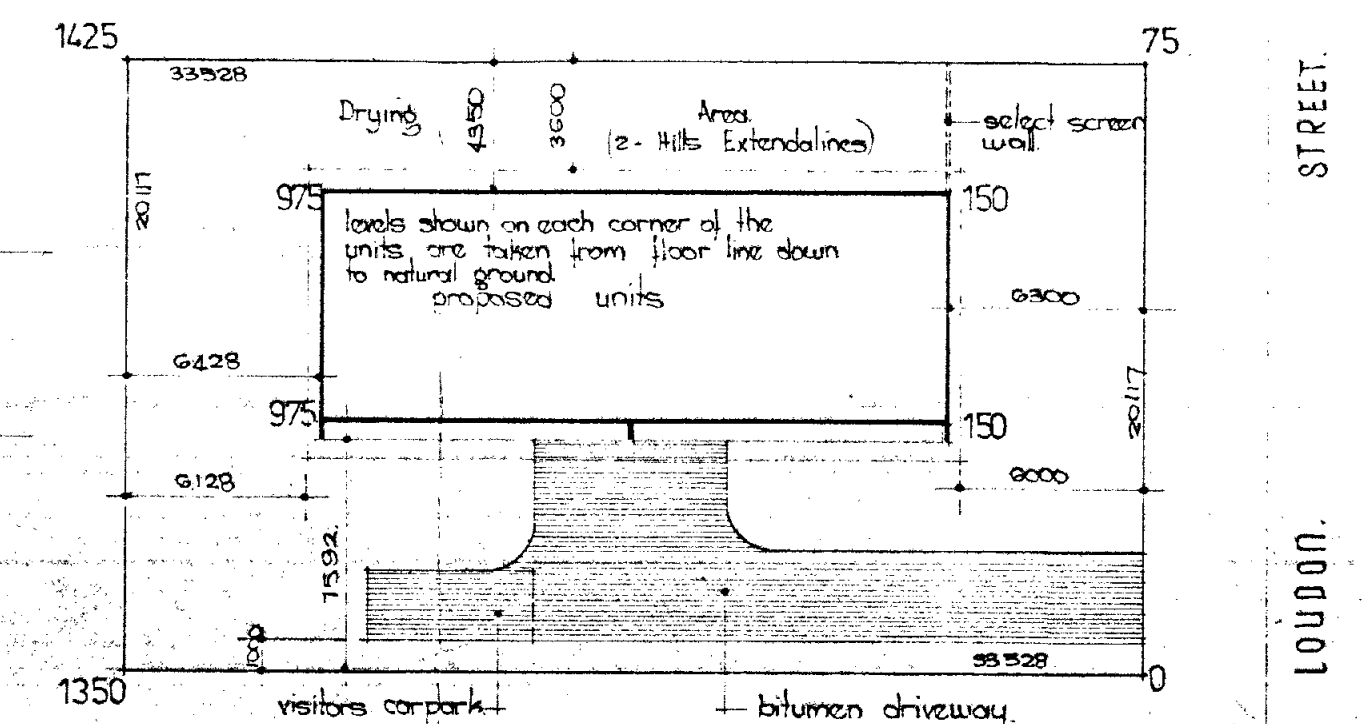
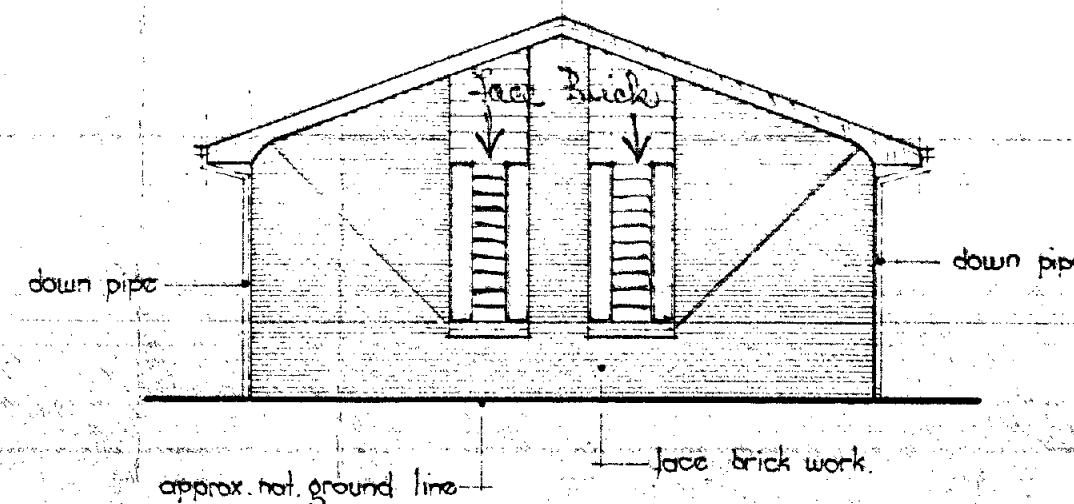


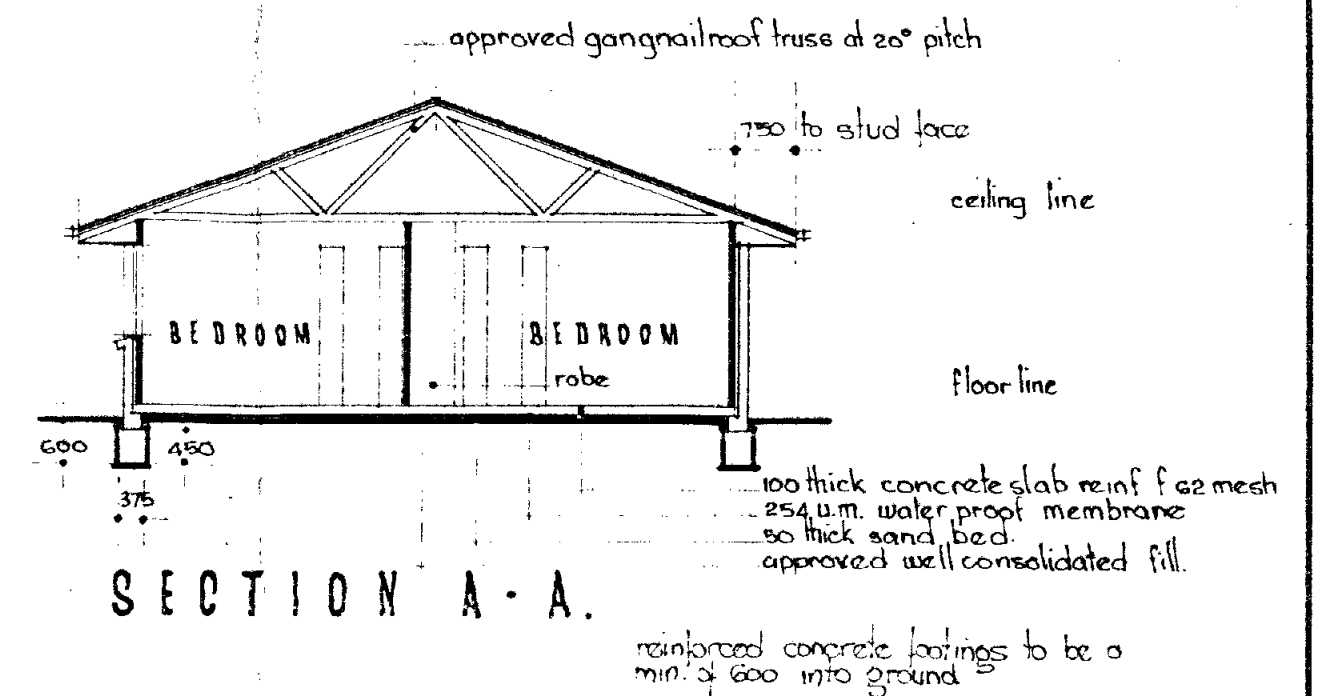

SUBJECT TO ALL PROPOSED  
VEHICLE CROSSINGS MUST BE  
KEPT CLEAR OF ANY SHRUBS  
OR TREES ON FOOTPATH.

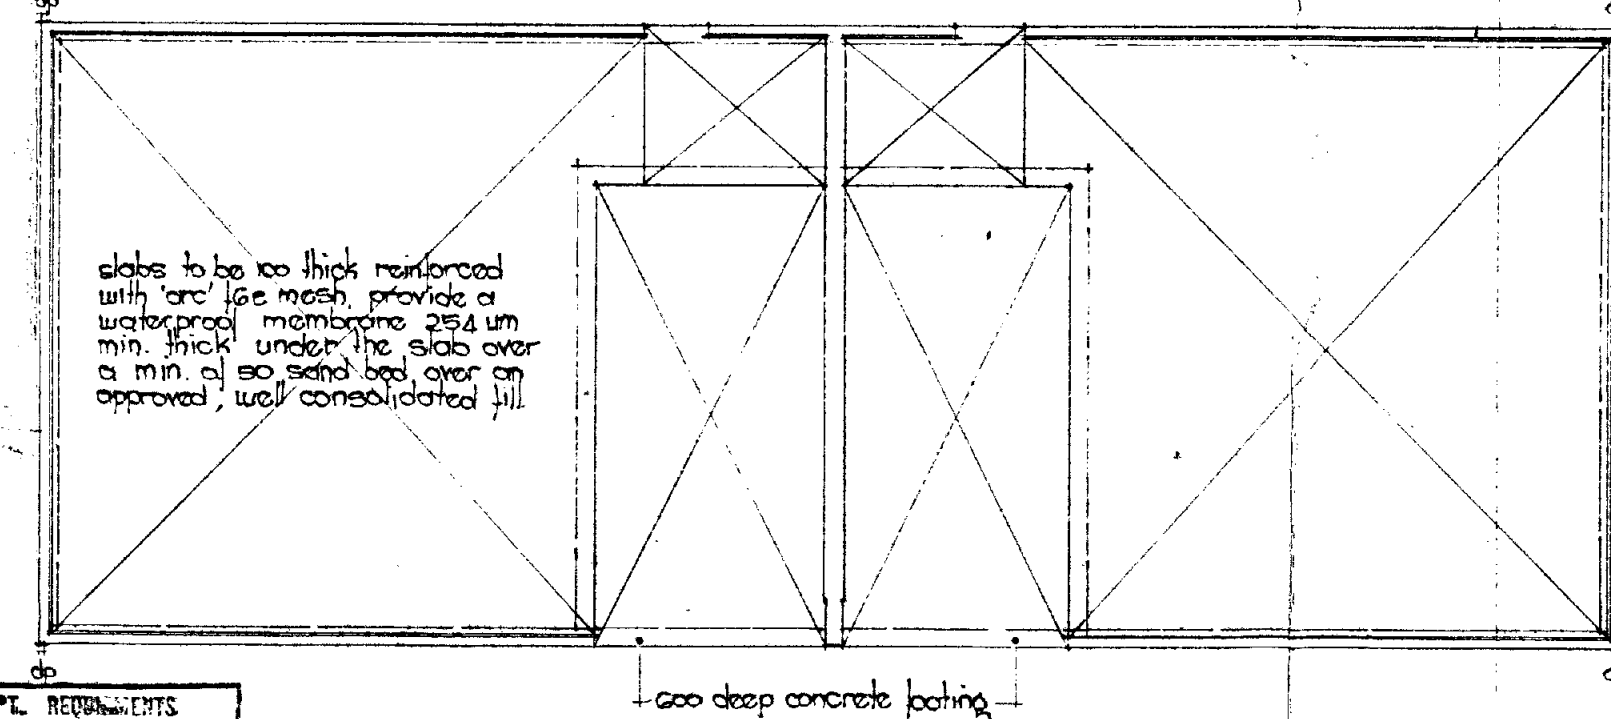

properly description.  
lot 1 on plan 145763.  
G/T 5304775

area of land: 9.674.482 m<sup>2</sup>  
area of units: 9.70.040 m<sup>2</sup>  
area of driveways  
and visitors carpark: 95.720 m<sup>2</sup>  
total - units, driveways + 265.760 m<sup>2</sup>

SIDEWAYS, ENTRANCES & ROADSWAYS on these <sup>1944</sup> ~~1943~~  
 is a permanent level is not <sup>obtained</sup> ~~obtained~~, no <sup>recovery</sup> ~~recovery~~  
 will be allowed for any subsequent <sup>attaching</sup> ~~attaching~~ to <sup>freedom</sup> ~~freedom~~  
 inside.  
 FROM CLASSIFIED - UNCLASSIFIED <sup>1944</sup> ~~1943~~  
 permits must be first <sup>checked</sup> ~~checked~~ before any <sup>work</sup> ~~work~~ is <sup>done</sup> ~~done~~  
 mention. The <sup>number</sup> ~~number~~ of <sup>classification</sup> ~~classification~~ is <sup>not</sup> ~~not~~ <sup>to</sup> ~~to~~ <sup>be</sup> ~~be~~ <sup>used</sup> ~~used~~ <sup>for</sup> ~~for~~ <sup>any</sup> ~~any~~ <sup>other</sup> ~~other~~ <sup>purpose</sup> ~~purpose~~ <sup>1944</sup> ~~1943~~

TOOWOOMBA CITY COUNCIL  
Examined and Passed by  
THE SEWERAGE H.C. DEPT.  
*[Signature]*  
Superintendent.  
Date: 11/3/77

**BUILDING PERMITS - SEWERAGE DEPT. REQUIREMENTS**

The applicant shall contain details of existing sewers, house drains and manholes and shall show on the drawings the location and levels of sewer mains and manholes and location of house drains where these are to be affected by the proposed work. In the absence of such details approval by the Sewerage Department shall not be deemed to approve proposals to excavate fill nor build over existing sewers, manholes or house drains.

## FOUNDATIONS CLEAR OF COUNCIL SEWERS

## FOUNDATION PLAN

TOOWOOMBA CITY COUNCIL  
EXAMINED AND PASSED BY  
THE BUILDING DEPT.  
BUILDING INSPECTOR  
DATE

TOOWOOMBA FIRE BRIGADE BOARD

This is sheet No. ONE of ONE sheets of

Interim Certificate of Approval

No. K110377/1

Signed [Signature]

Fire Safety Officer

Date 11th March 1977

|              |                  |
|--------------|------------------|
| <b>Drawn</b> | Bruce G. Weiner. |
| <b>Scale</b> | 1:100. 18250.    |
| <b>Date</b>  | 22 - 12 - 76.    |