

14/05/2026

LEGEND

MAJOR CONTOUR NS (2.50m)

MINOR CONTOURS (0.50m)

30413.CC.003 EXISTING SITE LAYOUT PLAN

DRAWING NO.	REFERENCE DRAWING TITLE	REV	DATE	REVISION DESCRIPTION	DRAWN	CHECKED	DESIGN	SUBMITTAL DATE	DATE FOR APPROVAL	APPROVED
		1	05/07/2018	ISSUED FOR TENDER AND REVISED PEEDELOT SITE LAYOUT PLAN	RDC	SL	SL	SL		
		2	16/07/2018	ISSUE FOR INFORMATION						



OWNER	BT	DATE	TITLE	
DRAWN		03/07/2018		
DATE CHECKED	SL	03/07/2018	MORT & CO GRASSDALE FEEDLOT EXPANSION - STAGE 3 EXISTING SITE LAYOUT PLAN	
DESIGN				
ENGINEER'S CHECK			PROJECT NO. 30413	DRAWING NO.
DATE - BY			30413.CC.003	1
PROJECT APPROVAL			SCALE 1:7500	DATE 03/13/CC.003 Existing Site Layout Plan - R11.dwg
			10	12

NOTE:

1. ESTIMATED CLAY LINER VOLUMES ARE TO BE ADDED AS CUT VOLUME TO EARTHWORKS QUANTITIES
2. REFER DETAIL ON DWG. Nos. 30413.CC.011

TOOWOOMBA REGIONAL COUNCIL

APPROVED PLAN

referred to in Council's Decision Notice dated

6 August 2026

This plan is subject to conditions of Approval Number

MCUI/2017/346/D

Assessment Manager

LEGEND


- 350.0 MAJOR CONTOUR NS (2.50m)
- MINOR CONTOURS (0.50m)
- 347.5 MAJOR CONTOUR DESIGN (2.50m)
- MINOR CONTOURS DESIGN (0.50m)
- FLOW DIRECTIONS
- DROP CHUTE

ESTIMATED EARTHWORKS

ITEMS	UNITS	AMOUNT	REMARKS
HOLDING POND	cu.m.	156,264.81	CUT
SEDIMENT BASIN A	cu.m.	43,903.97	CUT
SEDIMENT BASIN B	cu.m.	38,651.37	CUT
CHANNELS	cu.m.	9,954.58	CUT

ESTIMATED CLAY LINER VOLUME

ITEMS	UNITS	AMOUNT
HOLDING POND	cu.m.	25,171.12
SEDIMENT BASIN A	cu.m.	10,603.14
SEDIMENT BASIN B	cu.m.	9,326.96

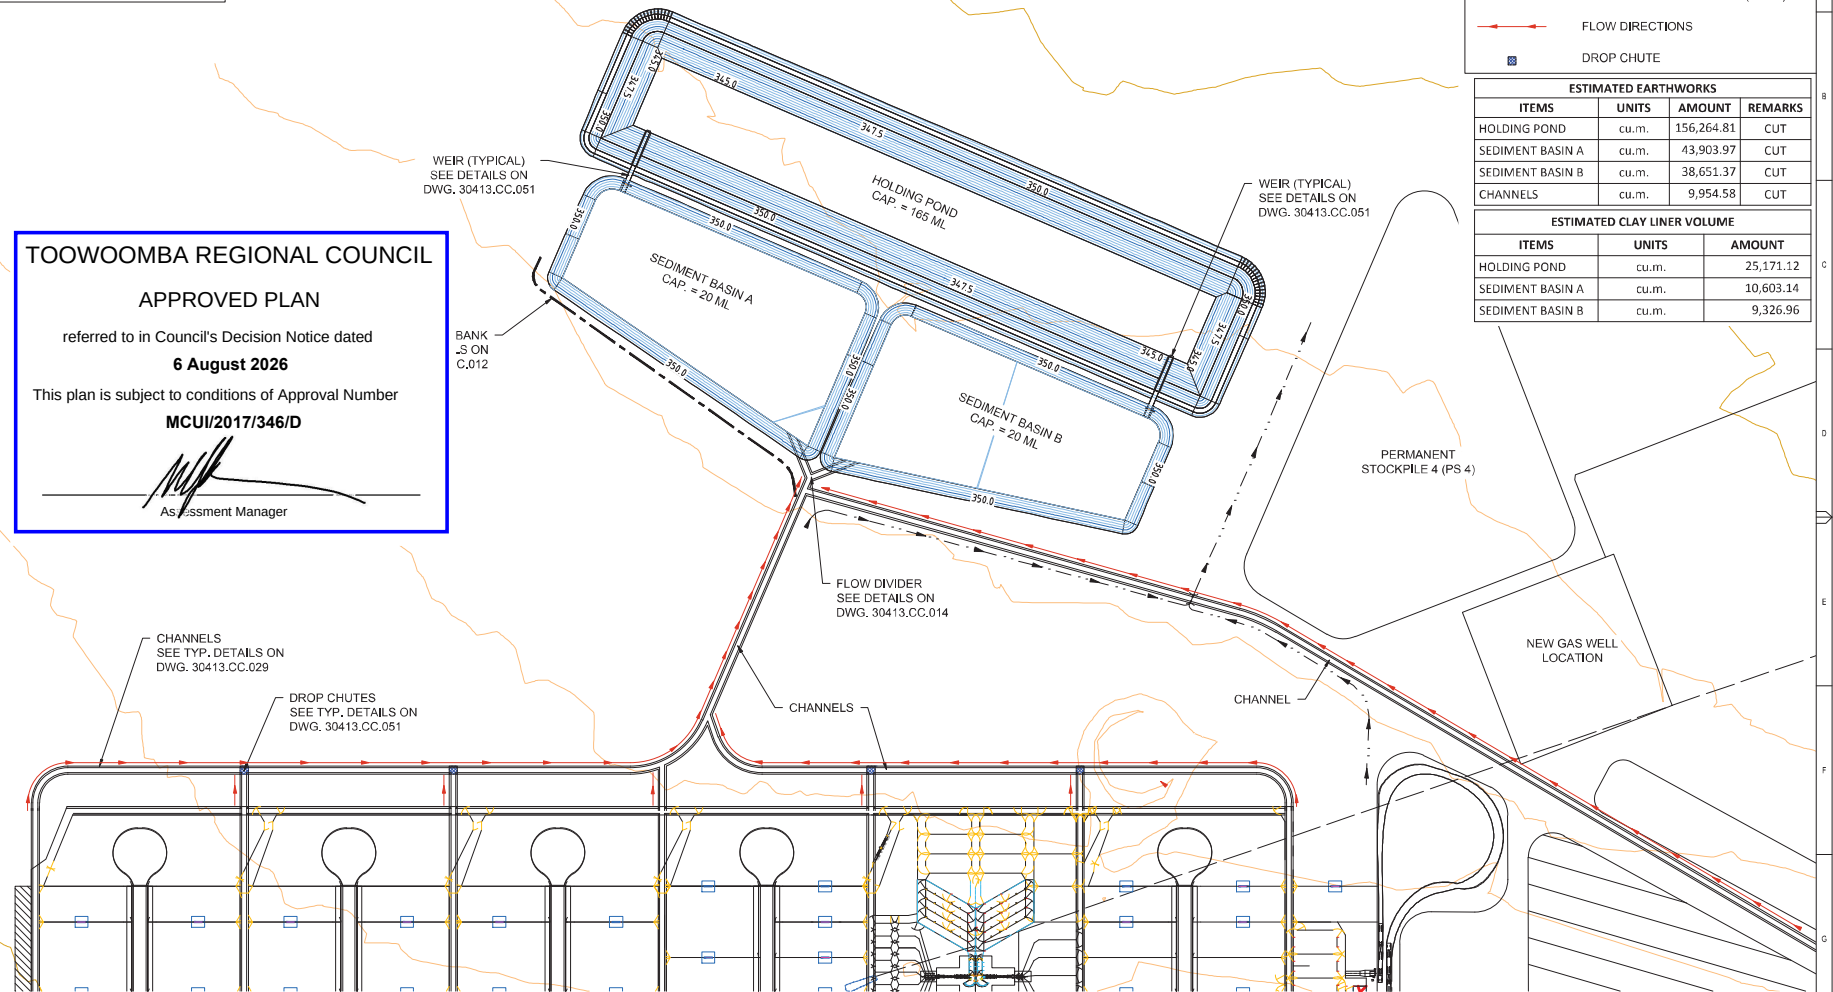

PERMANENT STOCKPILE 4 (PS 4)

NEW GAS WELL LOCATION

PLAN
SCALE 1:1500

ISSUED FOR TENDER

1:1500 @ A1
1:3000 @ A3

DRAWING NO.	REFERENCE DRAWING TITLE	REV	DATE	REVISION DESCRIPTION	DESIGN	CHECK	DATE	PROJECT
30413.CC.010	HOLDING POND AND SEDIMENT BASIN	1	13/07/2018	ISSUED FOR TENDER AND REVISED SEDIMENT BASIN LAYOUT	RDC	SL	SL	
		2	13/07/2018	ISSUED FOR TENDER AND REVISED FEEDLOT LAYOUT PLAN & REVISED CHANNEL VOLUMES	RDC	SL	SL	
		3	13/07/2018	ISSUED FOR TENDER AND REVISED FEEDLOT LAYOUT PLAN & REVISED CHANNEL VOLUMES	RDC	SL	SL	
		4	13/07/2018	ISSUED FOR TENDER AND REVISED FEEDLOT LAYOUT PLAN & REVISED CHANNEL VOLUMES	RDC	SL	SL	
PREPARED BY:
EnviroAg
Australia
TOOWOOMBA OFFICE
PO BOX 411
15 FOUNDRY ST
TOOWOOMBA QLD 4300
T: 07 4338 2228
PROJECT
30413
DRAWING OFFICE
TOOWOOMBA

DRAWN BY: RDC
DWG CHECK: SL
DESIGN: SL
PROJECT NO: 30413
DRAWING NO: 30413.CC.010
SCALE: AS SHOWN

DATE: 13/07/2018
PROJECT: MORT & CO GRASSDALE FEEDLOT EXPANSION - STAGE 3 HOLDING POND AND SEDIMENT BASINS
DRAWING NO: 30413.CC.010
SCALE: AS SHOWN

REVISION: 2
DATE: 13/07/2018
BY: RDC

LEGEND

- 350 MAJOR CONTOUR NS (2.50m)
- MINOR CONTOURS (0.50m)
- FLOW DIRECTIONS

ISSUED FOR TENDER


TOOWOOMBA REGIONAL COUNCIL

APPROVED PLAN

referred to in Council's Decision Notice dated
6 August 2026

This plan is subject to conditions of Approval Number
MCUI/2017/346/D

[Signature]
 Assessment Manager

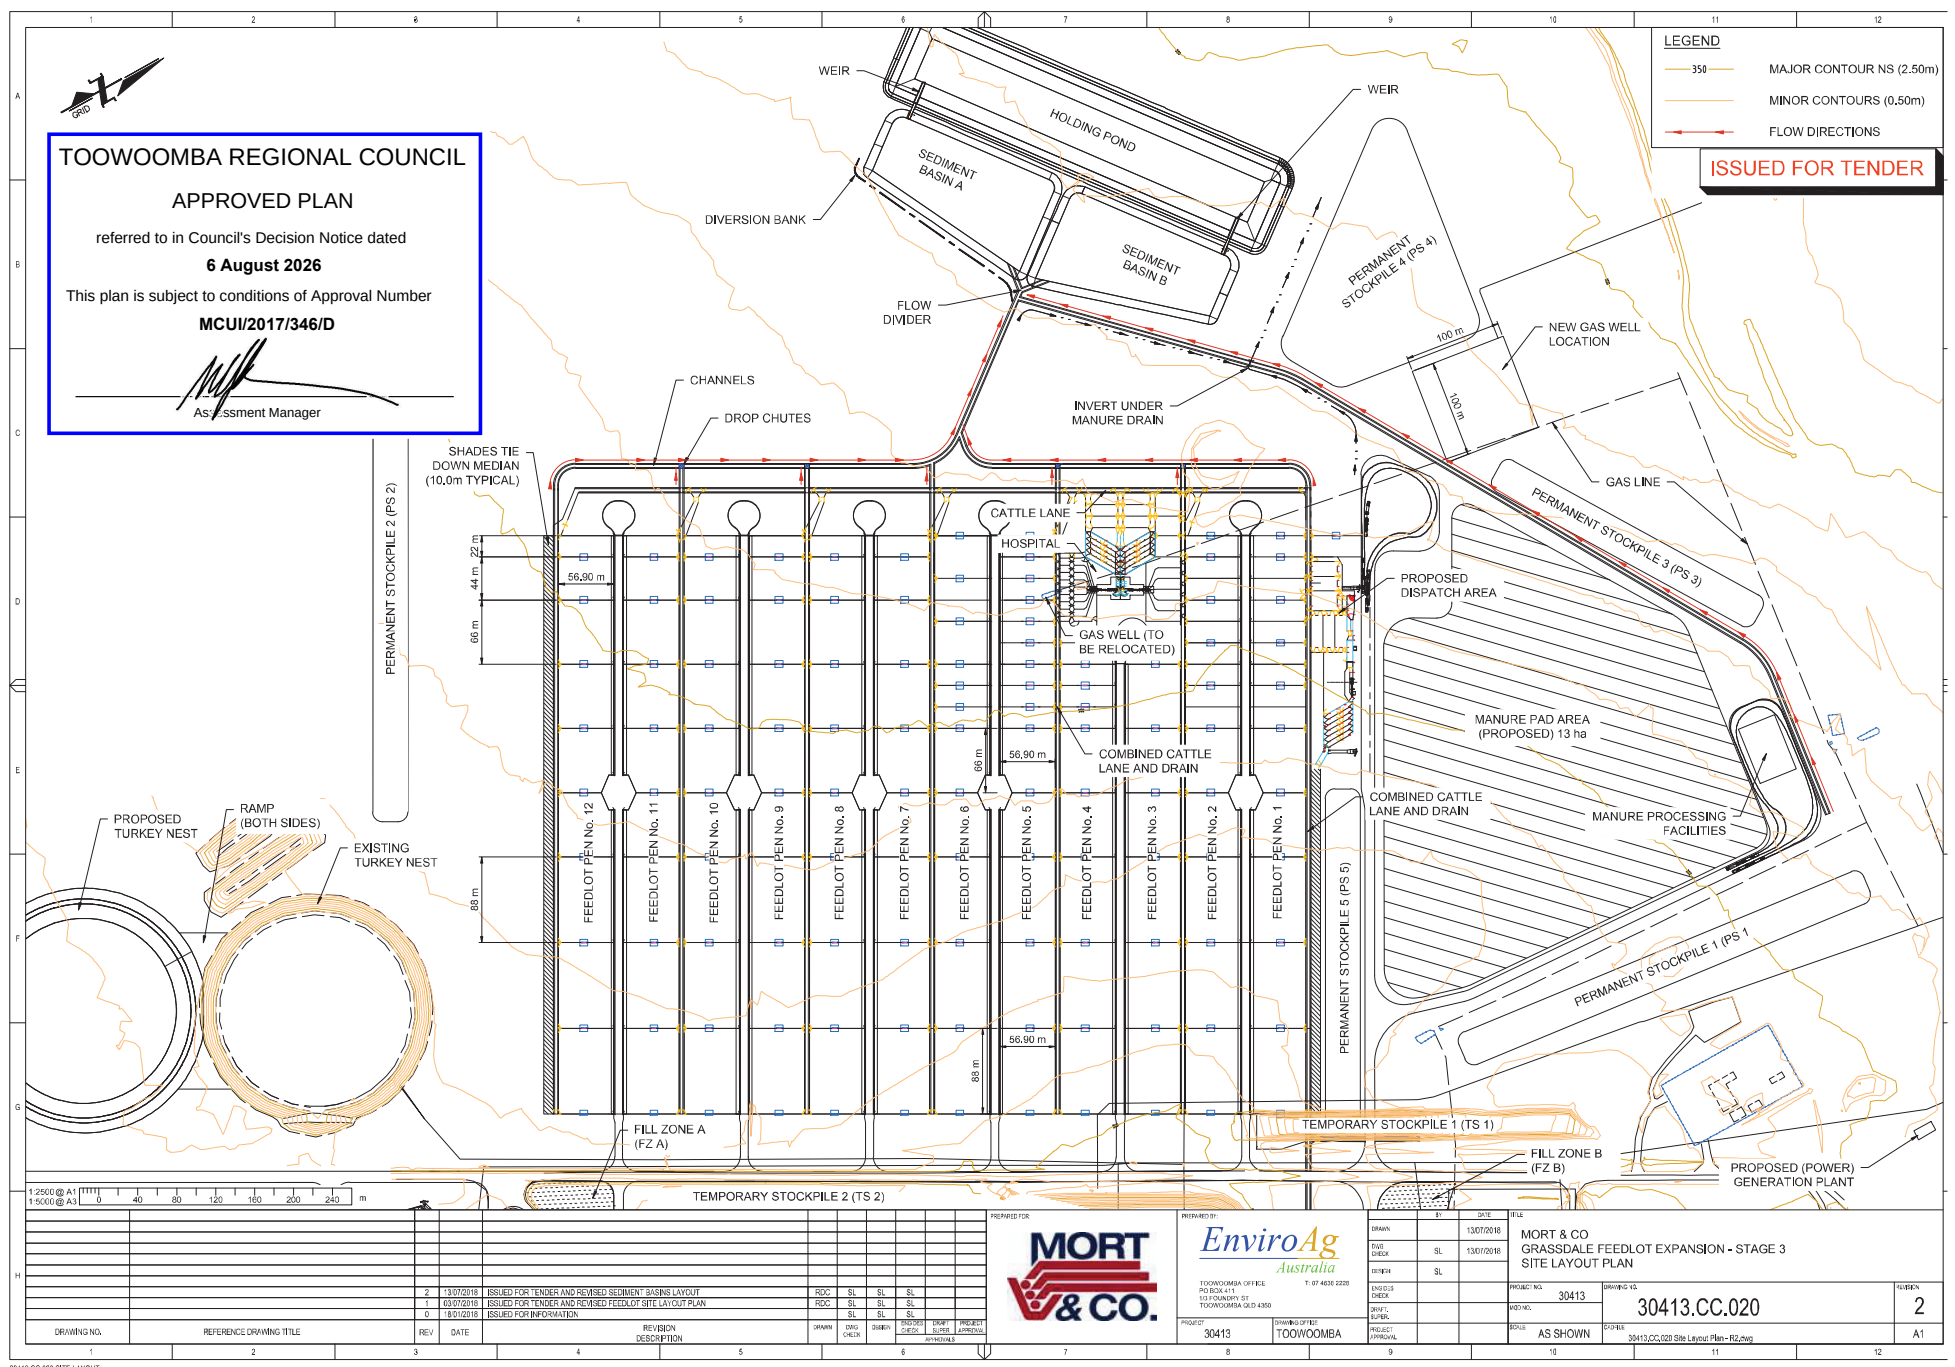

DRAWING NO.	REFERENCE DRAWING TITLE	REV	DATE	REVISION DESCRIPTION	DRAWN	CHECK	DESIGN	PROJECT	APPROVAL
1									
2									
3									
4									
5									
6									
7									
8									
9									
10									
11									
12									

PREPARED FOR: **MORT & CO.**

PREPARED BY: **EnviroAg Australia**

TOOWOOMBA OFFICE
 PROJECT 30413
 115 FOUNDRY ST
 TOOWOOMBA QLD 4300

1: 07 4536 2220

PROJECT: 30413 DRAWING OFFICE: TOOWOOMBA

DATE	BY	REVISION
13/07/2018	SL	1
13/07/2018	SL	2
13/07/2018	SL	3

PROJECT NO: 30413 DRAWING NO: 30413.CC.020

PROJECT: MORT & CO GRASSDALE FEEDLOT EXPANSION - STAGE 3 SITE LAYOUT PLAN

SCALE: AS SHOWN

DATE: 13/07/2018

BY: AS SHOWN

PROJECT: 30413.CC.020 Site Layout Plan - R2,2wg

DATE: 13/07/2018


BY: AS SHOWN

PROJECT: 30413.CC.020 Site Layout Plan - R2,2wg

DATE: 13/07/2018

BY: AS SHOWN

PROJECT: 30413.CC.020 Site Layout Plan - R2,2wg

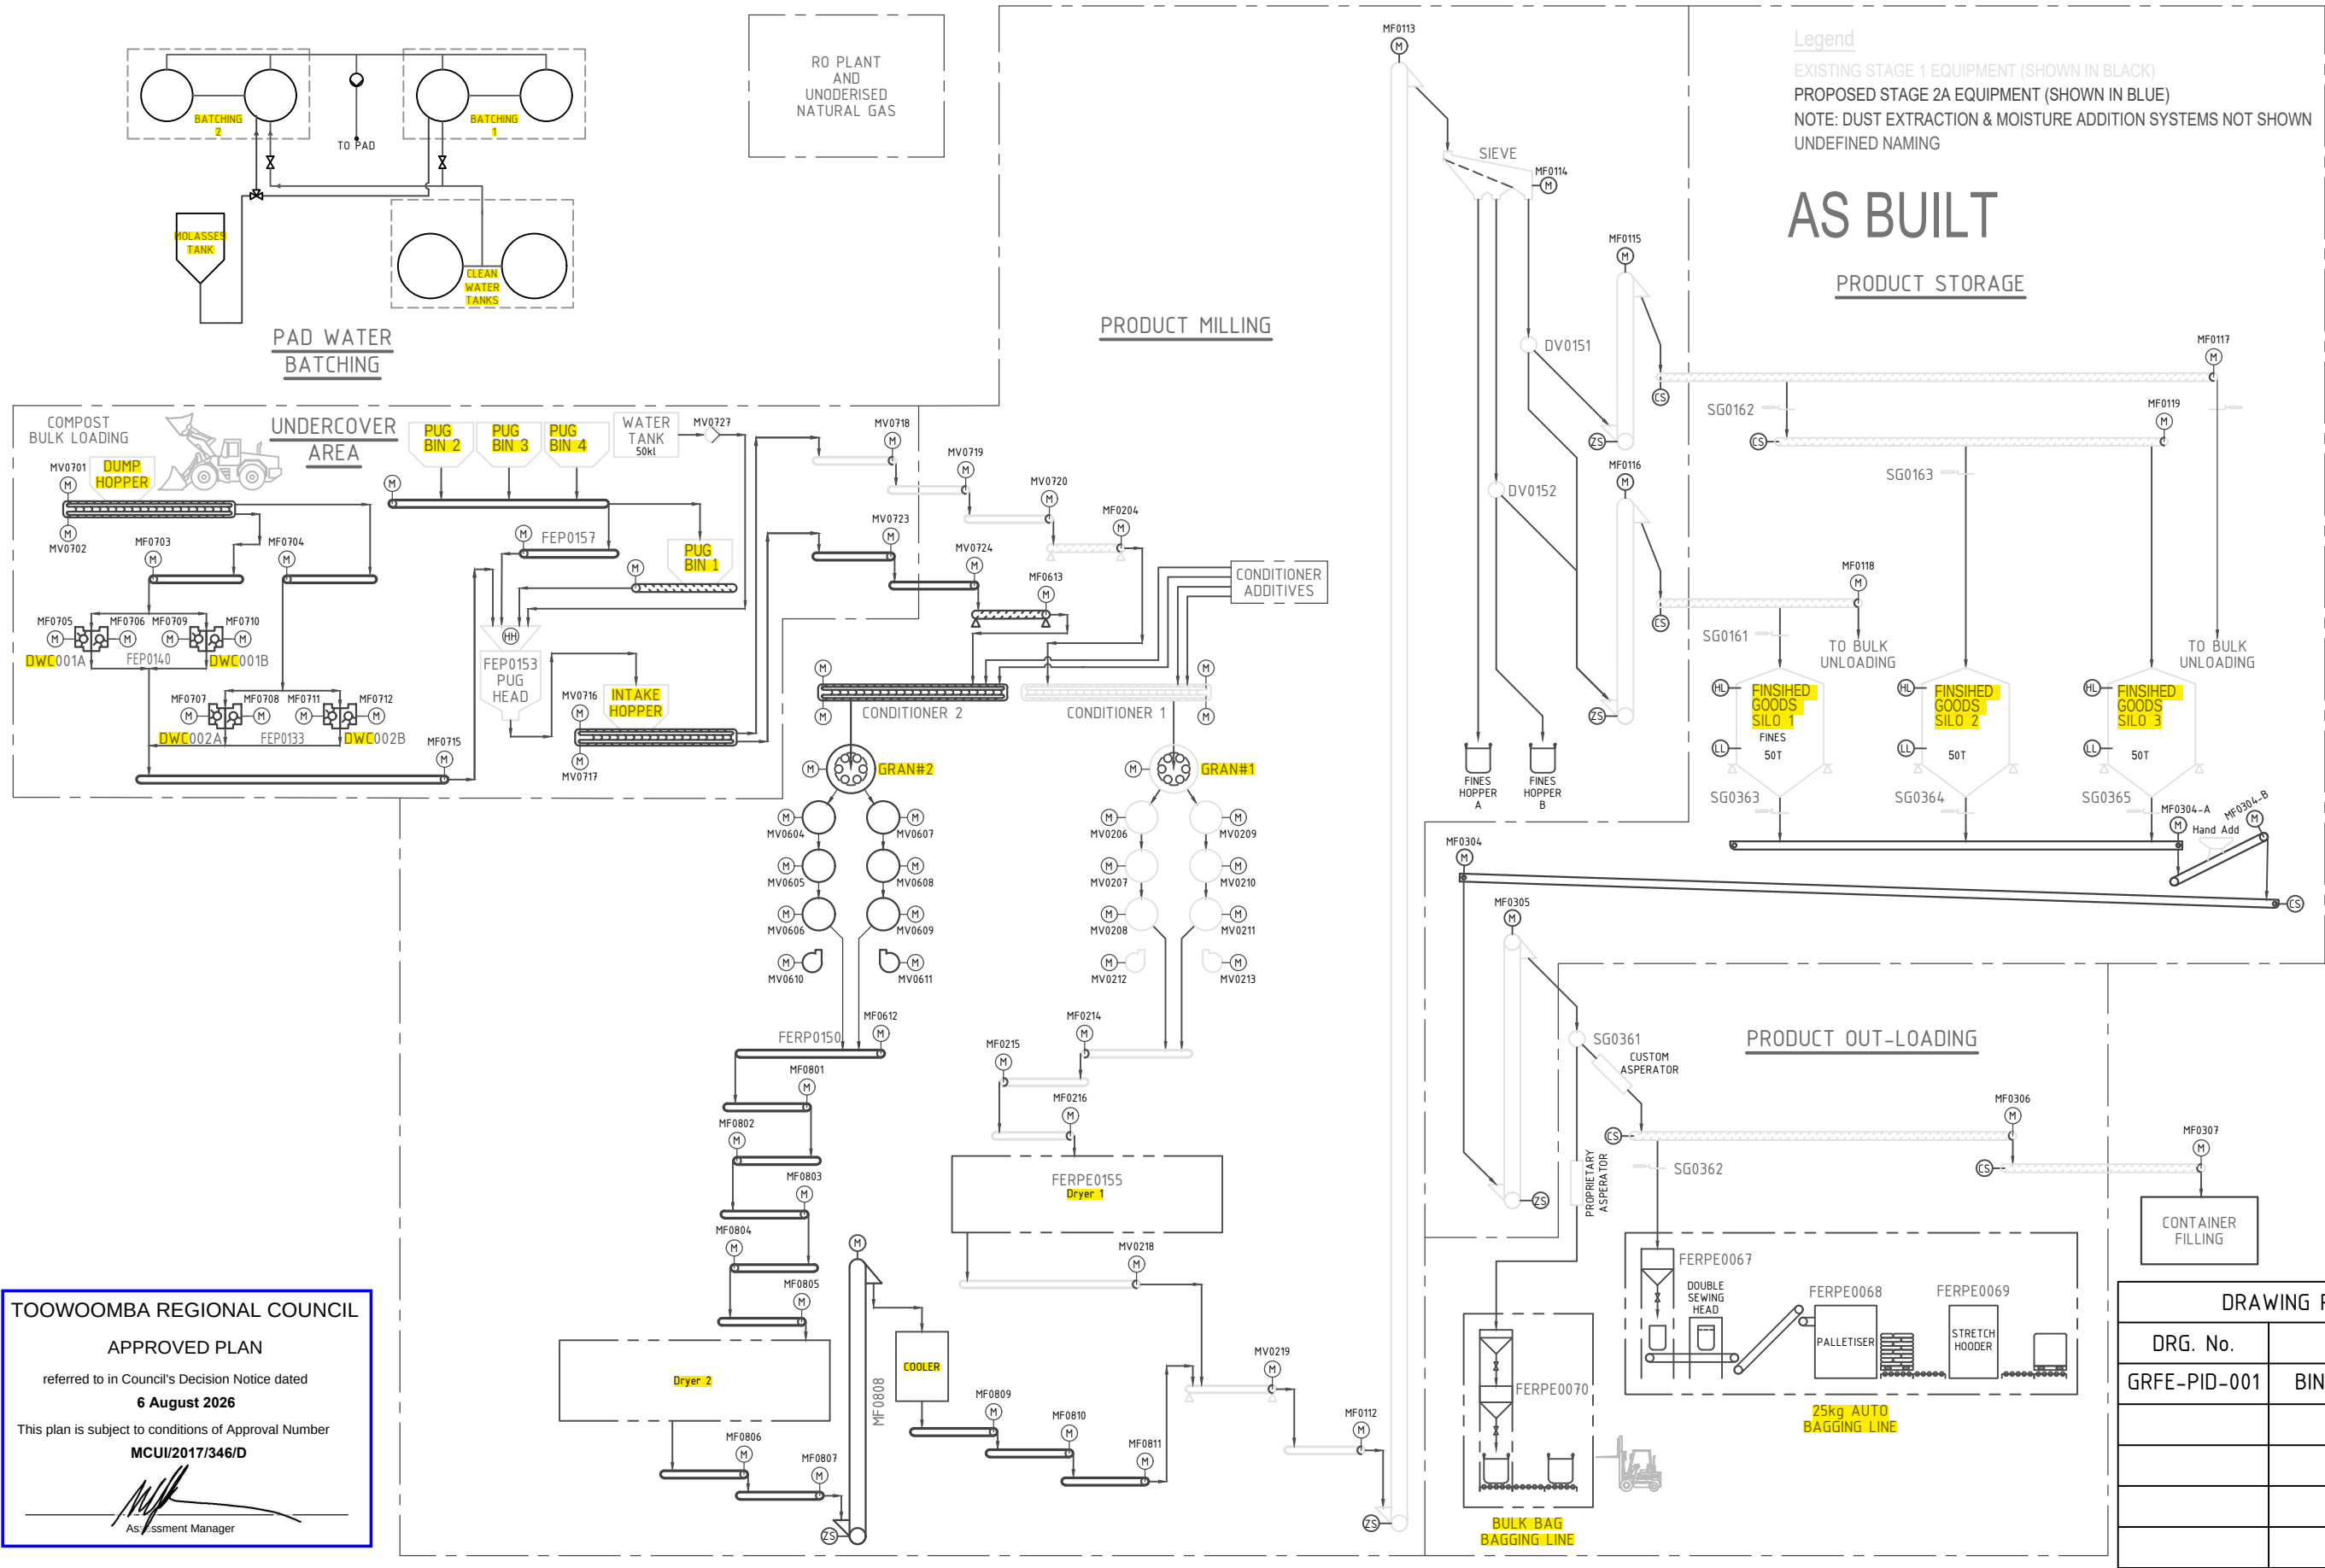

TOOWOOMBA REGIONAL COUNCIL

APPROVED PLAN

referred to in Council's Decision Notice dated
6 August 2026

This plan is subject to conditions of Approval Number
MCUI/2017/346/D

Assessment Manager


DRAWING REFERENCES	
DRG. No.	DESCRIPTION
GRFE-PID-001	BINDER 1 & MOLASSES

Rev.	Details	Drawn	Date
0	AS BUILT	JK	16/04/26
B	CONDITIONER ADDITIVES ADDED	JK	07/07/25
A	AS BUILT STAGE 1 & PROP STAGE 2	JK	02/08/22

Drawing Title:


GRASSDALE FRETLIERS
PROCESS FLOW DIAGRAM
AS BUILT

Drawn By: J. KILLALEA	Drawn Date: 06/06/25	Sheet Size: A3
Approved By:	Approved Date:	Scale: NTS
Drawing No.: GRFE-PFD-02		Revision No.: B

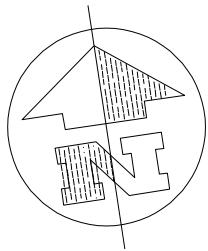

Legend

- Pedestrian Path (128m nom.)
- Pedestrian / Vehicle Shared Zone (60m nom.)
- Safety Bollards

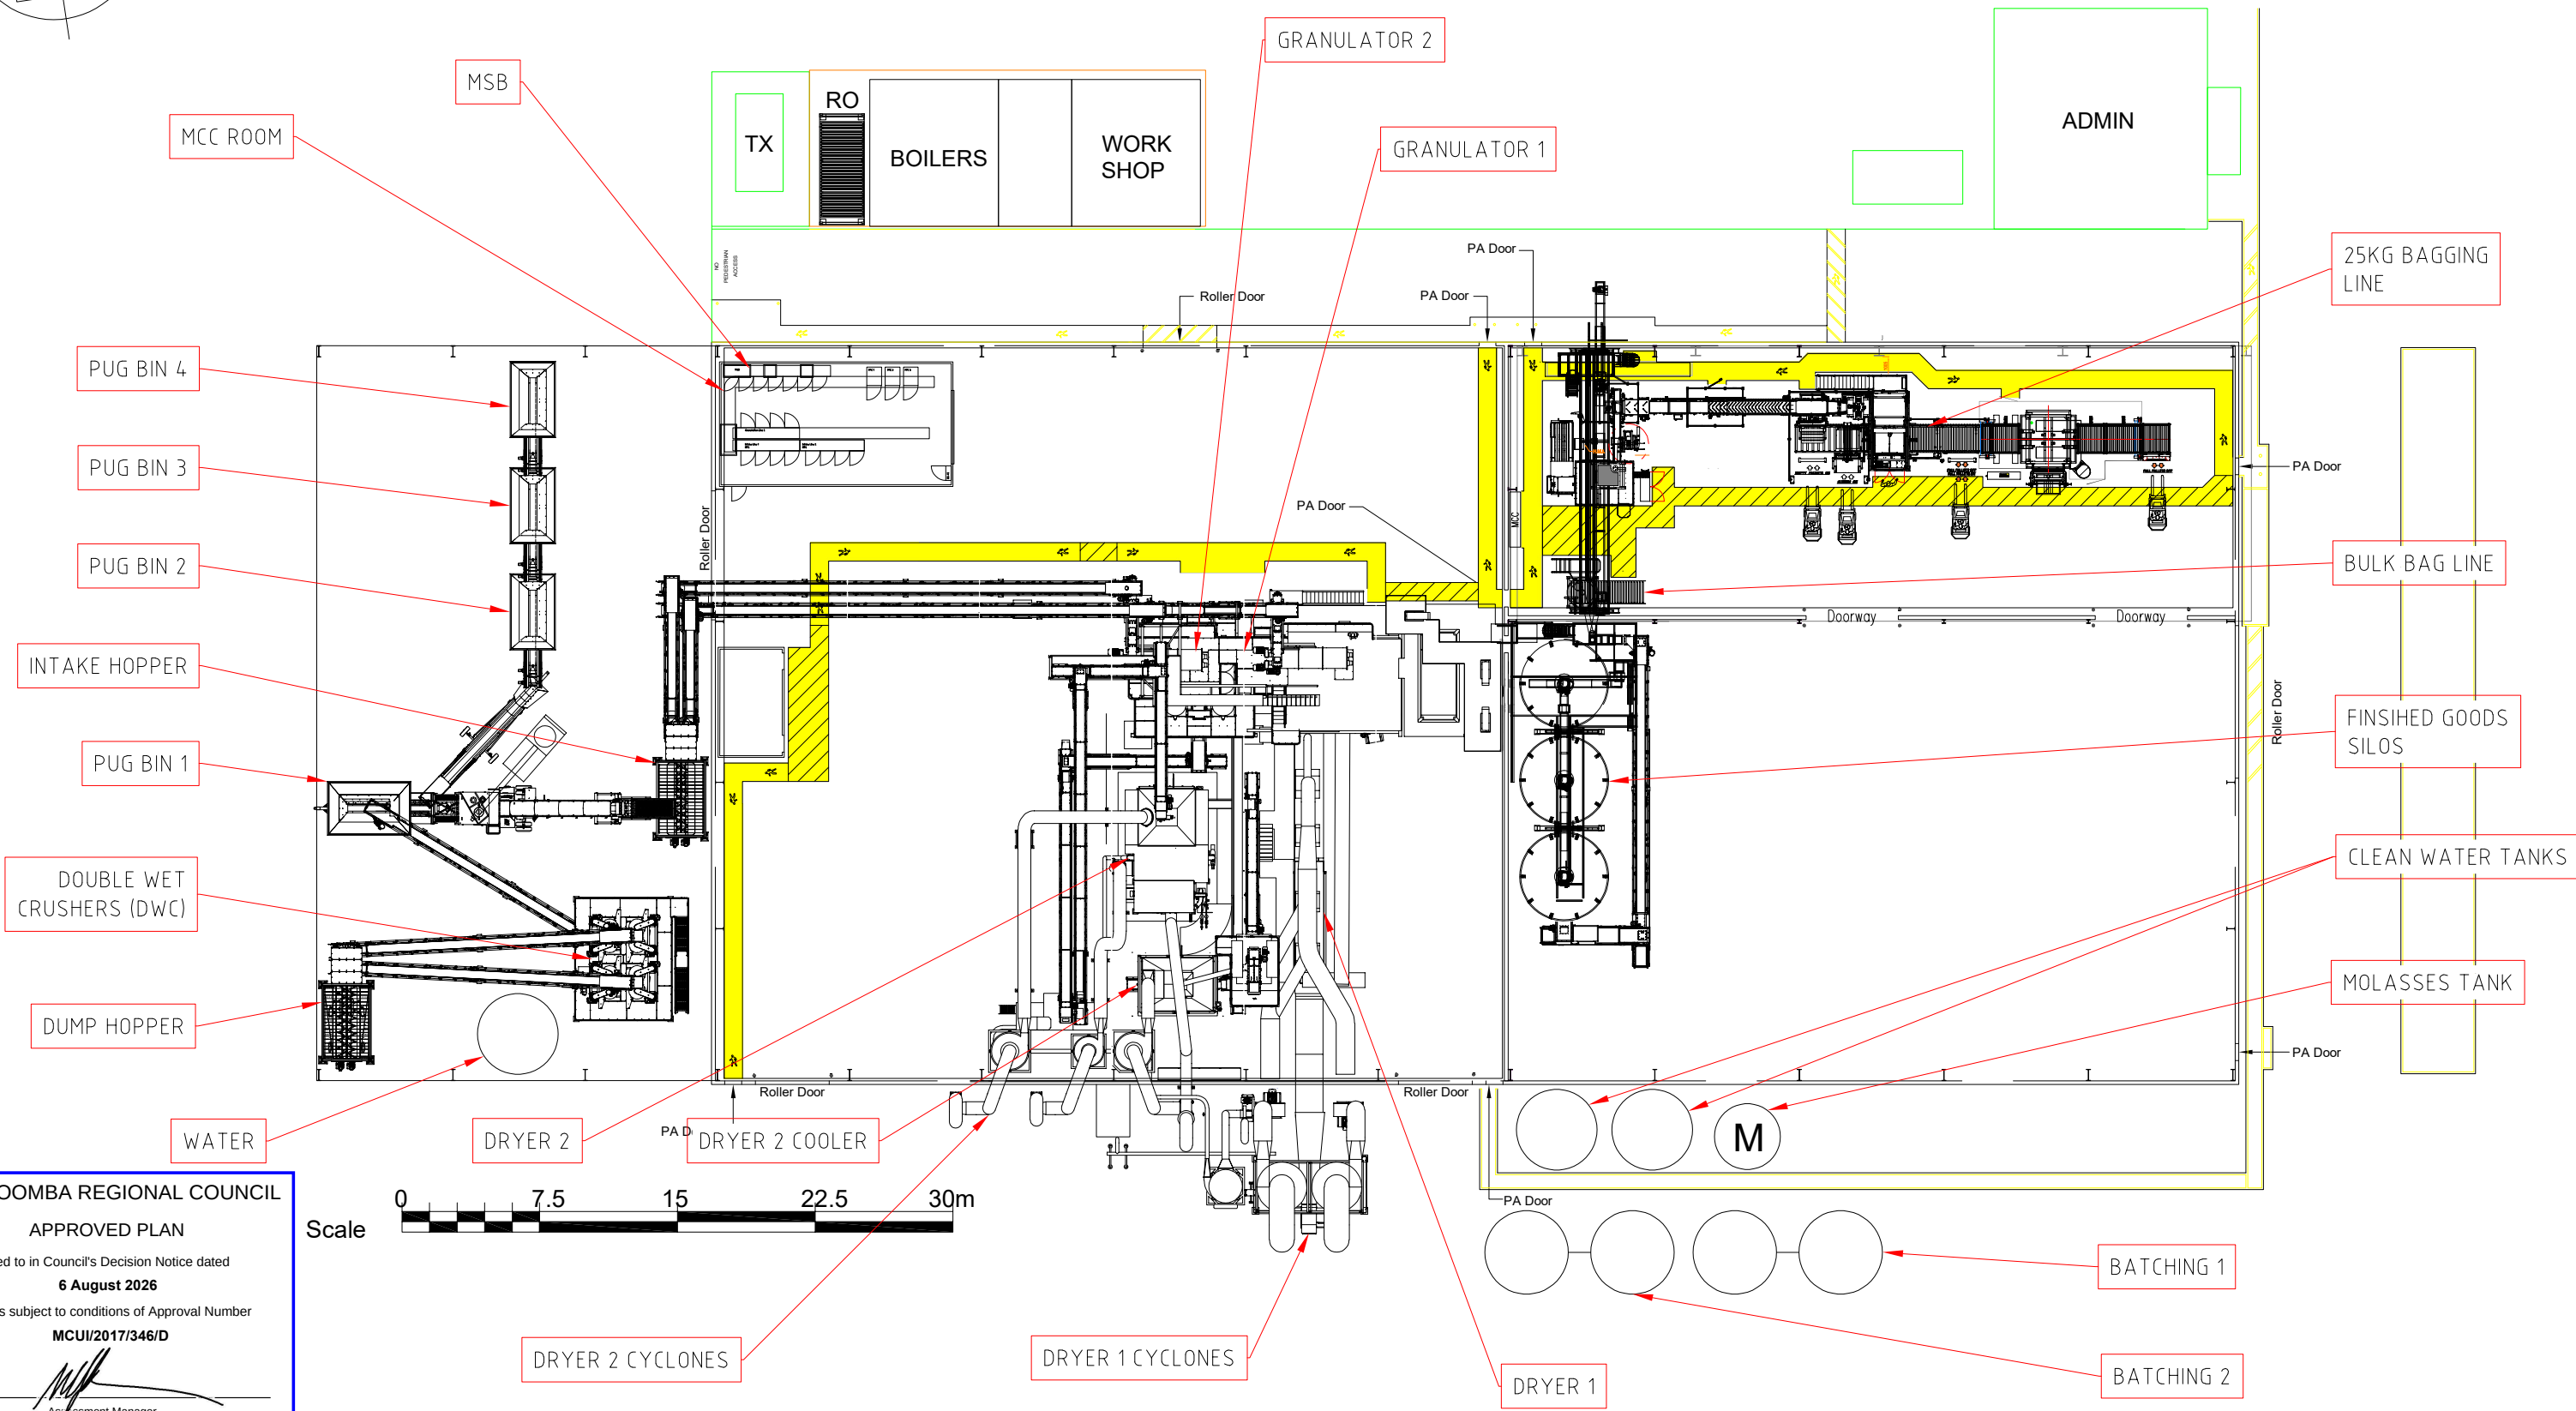

TOOWOOMBA REGIONAL COUNCIL
APPROVED PLAN
referred to in Council's Decision Notice dated
6 August 2026
This plan is subject to conditions of Approval Number
MCUI/2017/346/D

Assessment Manager

1	As Built	CPW	23/06/26
Rev.	Details	Drawn	Date



Drawing Title:
Mort & Co Fertilisers
Grassdale Facility
Prime Equipment Layout

Drawn By: CPW	Drawn Date: 23/06/26	Sheet Size: A3
Approved By:	Approved Date:	Scale: DNS
Drawing No.: GRFE-VMP-04	Revision No.: 1	

Z:_MasterXRefs\GRFL-Infrastructure-Roads-Existing_220314.dwg, Fertilisers Shed, 14/03/22 3:57:42 PM

TOOWOOMBA REGIONAL COUNCIL

APPROVED PLAN

referred to in Council's Decision Notice dated

6 August 2026


This plan is subject to conditions of Approval Number

MCUI/2017/346/D


Assessment Manager



Scale

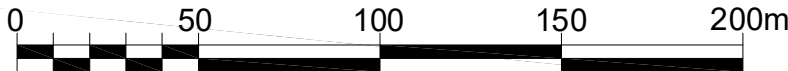

1	As Built	CPW	22/04/26
Rev.	Details	Drawn	Date



Drawing Title:
Mort & Co Fertilisers
Grassdale Facility
Factory and Pad

Drawn By: CPW	Drawn Date: 23/06/26	Sheet Size: A3
Approved By:	Approved Date:	Scale: 1:1000
Drawing No.: GRFE-VMP-05		Revision No.: 1

TOOWOOMBA REGIONAL COUNCIL

APPROVED PLAN


referred to in Council's Decision Notice dated

6 August 2026

This plan is subject to conditions of Approval Number

MCUI/2017/346/D


Assessment Manager

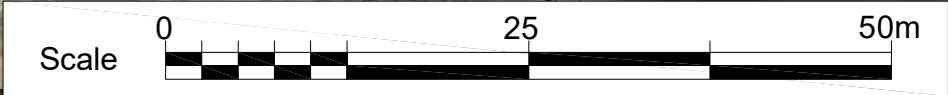

1	As Built	CPW	22/04/26
Rev.	Details	Drawn	Date



Drawing Title:

Mort & Co Fertilisers
Grassdale Facility
Factory General Arrangement

Drawn By: CPW	Drawn Date: 23/06/26	Sheet Size: A3
Approved By:	Approved Date:	Scale: 1:250
Drawing No.: GRFE-VMP-06		Revision No.: 1