


**RECEIVED**  
30/06/2026  
**TOOWOOMBA**  
**REGIONAL COUNCIL**




## **APPENDIX E – FACTORY & PAD PLANS**

*Mort & Co*

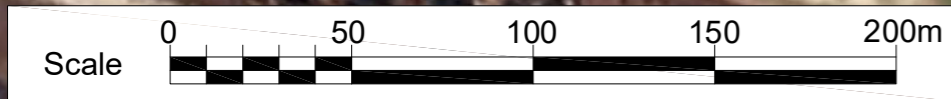


1	As Built	CPW	22/04/26
Rev.	Details	Drawn	Date

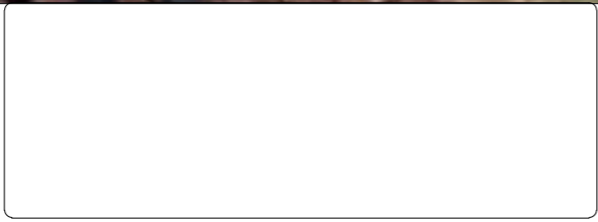

Drawing Title:  
 Mort & Co Fertilisers  
 Grassdale Facility  
 Factory and Pad

Drawn By: CPW	Drawn Date: 23/06/26	Sheet Size: A3
Approved By:	Approved Date:	Scale: 1:1000
Drawing No.:	Revision No.:	
GRFE-VMP-05	1	

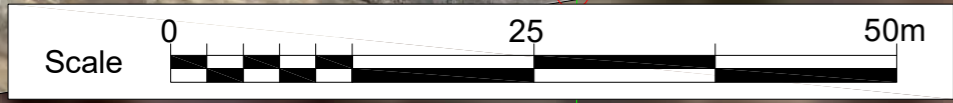

1	As Built	CPW	22/04/26
Rev.	Details	Drawn	Date



Drawing Title:  
 Mort & Co Fertilisers  
 Grassdale Facility  
 Factory General Arrangement

Drawn By: CPW	Drawn Date: 23/06/26	Sheet Size: A3
Approved By:	Approved Date:	Scale: 1:250
Drawing No.: GRFE-VMP-06	Revision No.: 1	